


Walter B. Lindley, President
 Lindco Development Inc. 4/19/04

[Signature]
 McCoy's Building Supply Center

EXHIBIT A

NO.	DATE	DESCRIPTION	APPROVED

DESIGNED DBR
 DRAWN BB
 CHECKED
 DATE JAN 2004

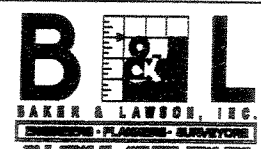

The seal appearing on this document was authorized by Douglas B. Roessler P.E. 58738
[Signature]
 Date 4-15-04

OWNER:
McCoy BUILDING SUPPLY CENTERS
 1200 I.H. 35 NORTH
 P.O. BOX 1028
 SAN MARCUS, TX. 78667

SCALE:
 PLAN: 1" = 50'
 PROFILE:
 HORIZONTAL:

McCOY
 BRAZORIA, TEXAS
 GRADING, PAVING, DRAINAGE, WATER,

SHEET OF SHEETS
SITE LAYOUT